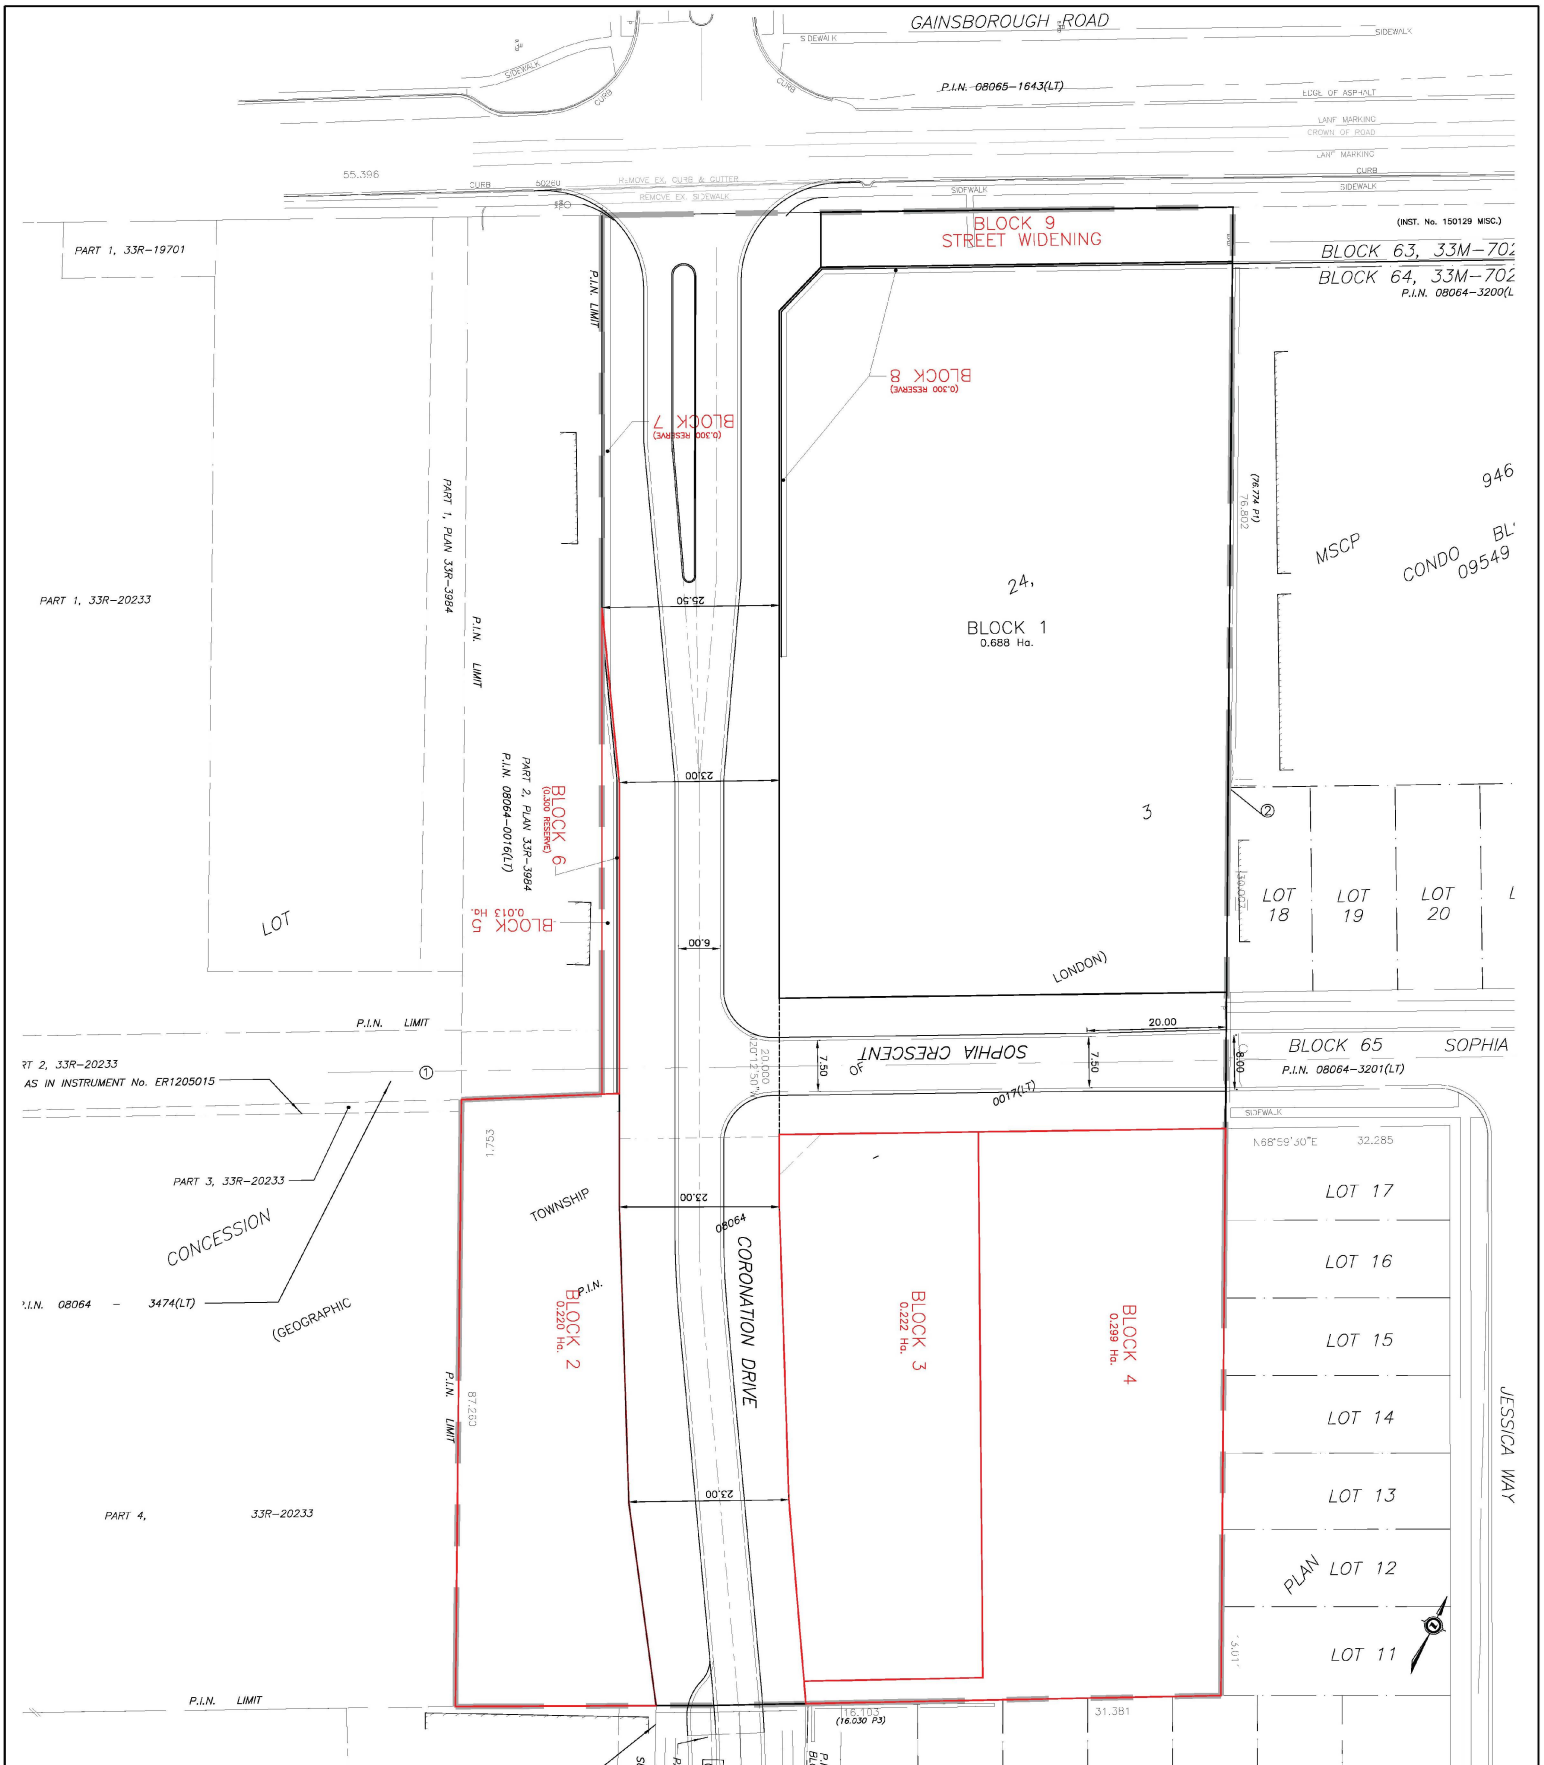

954 GAINSBOROUGH ROAD

2774800 ONTARIO INC.

ENG PLUS Engineers and Building Designers

DRAWN BY: VJS
PLOTTED: APRIL 13, 2023
SCALE: 0 2.5 5 10
PROJECT No: 20-231

SCHEDULE OF LAND USE

LAND USE	(HECTARES)	PERCENTAGE
RESIDENTIAL BLOCK 1	0.688	29.0
RESIDENTIAL BLOCKS 2, 3 AND 4	0.741	31.3
ROAD WIDENING BLOCK 9	0.213	9.0
RESERVE BLOCKS 5, 6, 7 AND 8	0.027	1.1
ROAD ALLOWANCES	0.701	29.6
CONVEYED LAND (SOPHIA CRESCENT)	0.001	0.0
TOTAL AREA	2.369	100%

REQUIREMENTS of SECTION 51 (17) of the PLANNING ACT
(a) KNOWN DEPTH AND AVAILABILITY OF SERVICES
(b) SEE PLAN
(c) SEE PLAN
(d) SEE PLAN
(e) SEE PLAN
(f) SEE PLAN
(g) SEE PLAN
(h) SEE PLAN
(i) SEE PLAN
(j) SEE PLAN

SELECT TO BE CONDITIONAL IF ANY, SET FORTH IN OUR LETTER DATED ON OR ABOUT THE DATE OF THE PLANNING ACT PRE-CONSULTATION UNDER SECTION 51 (20) OF THE

SURVEYOR'S CERTIFICATE
I CERTIFY THAT THE BOUNDARIES OF THE LANDS TO BE SUBDIVIDED, AS SHOWN ON THIS PLAN, AND ADJACENT LANDS ARE ACCURATELY AND CORRECTLY SHOWN.
JAKE SKRIDOW ONTARIO LAND SURVEYOR
DILLON CONSULTING INCORPORATED
DATE

OWNER'S CERTIFICATE
I AUTHORIZE ASP SIGNS TO PREPARE AND SUBMIT THIS PLAN OF SUBDIVISION FOR APPROVAL.
ASP SIGNS
217430 ONTARIO INC.
DATE

DRAFT PLAN OF SUBDIVISION
954 GAINSBOROUGH ROAD
LEGAL DESCRIPTION
PART OF LOT 24, CONCESSION 3 (GEOGRAPHIC TOWNSHIP OF LONDON)
IN THE CITY OF LONDON
COUNTY OF MIDDLESEX